

**TOWN OF BLOOMING GROVE  
BUILDING DEPT. PERMIT APPLICATION**

P O BOX 358, BLOOMING GROVE, NY 10914  
Phone (845) 496-7011 X725 Fax (845) 496-1945

**WELL & SEWAGE DISPOSAL FACILITIES**

DATE: \_\_\_\_\_

PERMIT # \_\_\_\_\_

**WELLS**

\_\_\_\_ NEW        \$200.00  
\_\_\_\_ REDRILL    75.00  
\_\_\_\_ REPAIR      50.00

**SEPTIC**

\_\_\_\_ NEW/MAJOR REPAIR \$500.00  
\_\_\_\_ REPLACE TANK        250.00  
\_\_\_\_ REPLACE FIELDS      400.00  
\_\_\_\_ MINOR REPAIR        200.00

SECTION \_\_\_\_\_ BLOCK \_\_\_\_\_ LOT \_\_\_\_\_

APPLICANT NAME: \_\_\_\_\_ PHONE # \_\_\_\_\_

OWNER NAME: \_\_\_\_\_ PHONE # \_\_\_\_\_

MAIL ADDRESS: \_\_\_\_\_

PROPERTY LOCATION: \_\_\_\_\_

SEPTIC TANK: SIZE \_\_\_\_\_ TYPE \_\_\_\_\_ # OF BEDROOMS \_\_\_\_\_

ENGINEER: \_\_\_\_\_ PHONE # \_\_\_\_\_

CONTRACTOR/DRILLER: \_\_\_\_\_ PHONE # \_\_\_\_\_


**WELLS** - New well applications must include two sets of stamped engineer plans. To close out new or re-drill permits, the DEC well log and final water test results must be submitted.

**SEPTICS** - Major repair and field replacement applications must include two sets of stamped engineer plans. An inspection by the Town engineer must be scheduled before backfill is done. To close out these permits, a final as-built and certified engineer letter must be submitted. To close out a tank replacement permit, a sketch of the property showing the measurements off the house to the septic tank must be submitted - **sample attached**.

*A copy of the contractor/ driller's Workman's compensation and liability insurance must be submitted with application. The liability must name the Town of Blooming Grove as Certificate Holder AND Additional Insured.*

\_\_\_\_\_  
APPLICANT'S SIGNATURE

***PLEASE BE ADVISED: It is the owner/applicant's responsibility to submit proper paperwork, schedule inspections and re-inspections (if necessary) and to properly close out the permit. A building permit expires one year from the issue date. There will be a \$125.00 fee to close out and issue a CO or CC for an expired permit.***

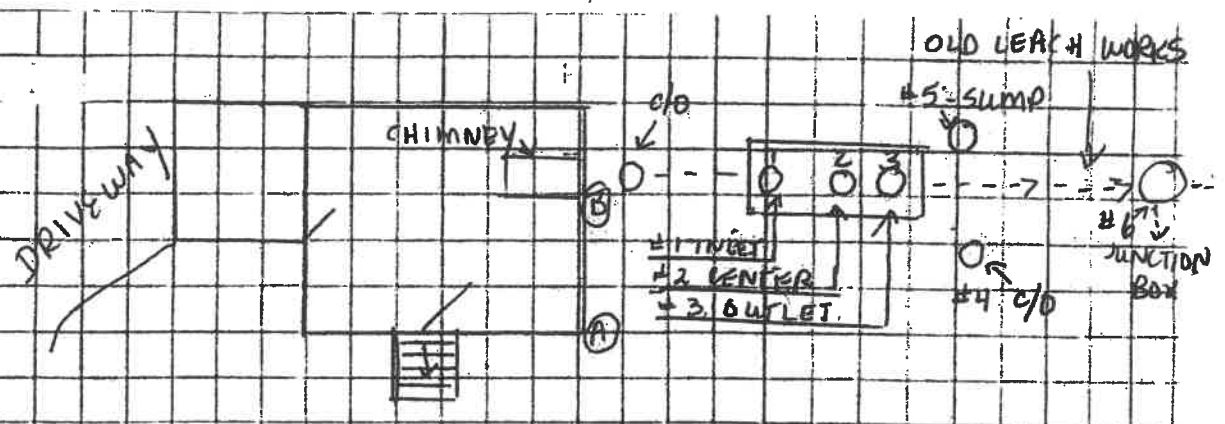

	A	B
1		
INLET	22'	14'
2		
CENTER	25'	19'5"
3		
OUTLET	28'	23'
4		
CLEANOUT	30'4"	31'
5		
SUMP	32'6"	26'
6		
JUNCTION BOX	35'	37'5"

COMMENTS:

1. INSTALL 1 NEW 1500 GAL. POLY SEPTIC TANK MFG. BY INFILTRATOR SYSTEMS

SAMPLE  
AS-BUILT